


CITY OF VANCOUVER, WASHINGTON

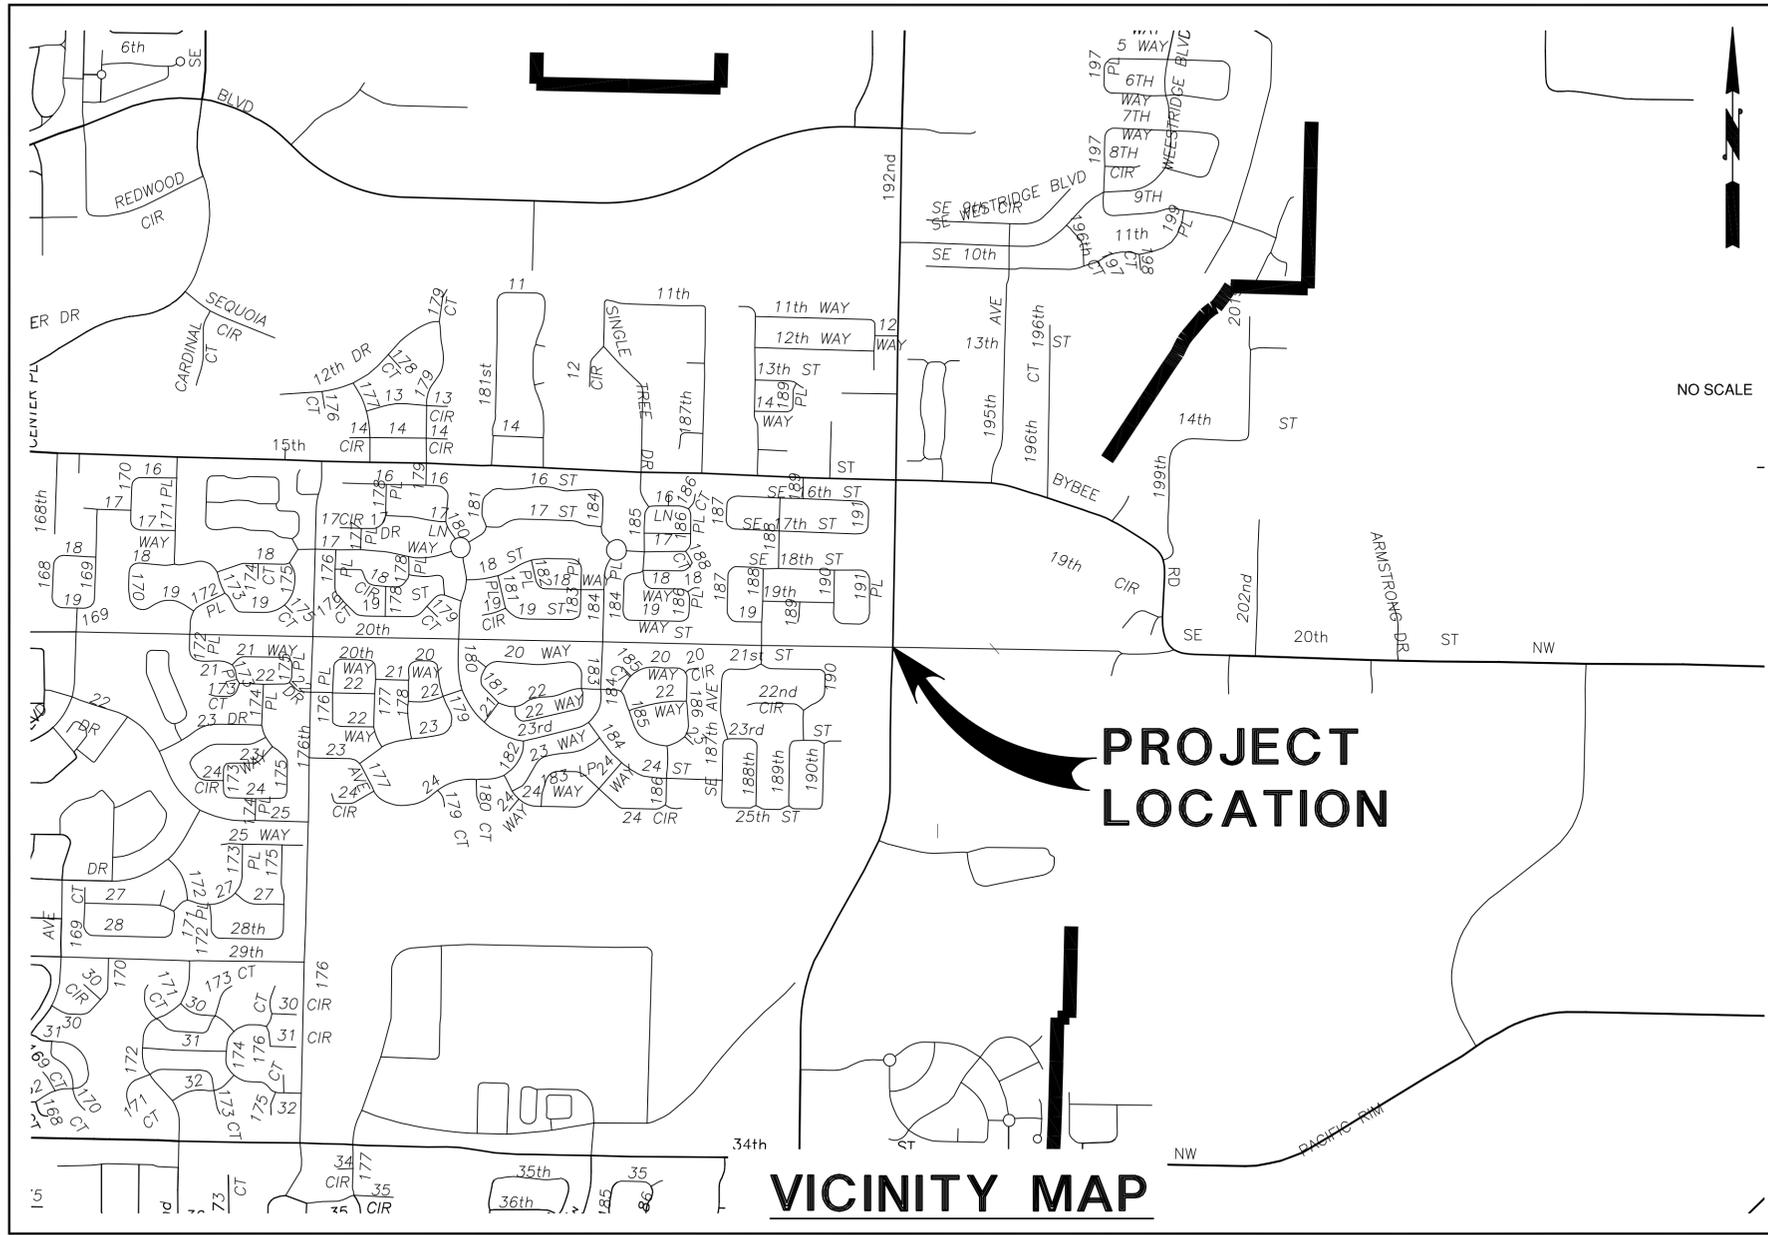

PLANS FOR PROPOSED PLAZA WEST AT 192ND

TRAFFIC SIGNAL MODIFICATION, ILLUMINATION, & SIGNING AND PAVEMENT MARKING PLANS

DECEMBER 2014
SHEET INDEX

GENERAL	SHT. NO.	CAT. NO.	DESCRIPTION
	1	G01	COVER SHEET
	2	G02	GENERAL NOTES, ABBREVIATIONS AND LEGEND
TRAFFIC SIGNAL PLANS	3	S01	SIGNAL MODIFICATION PLAN
ILLUMINATION PLANS	4	IL01	ILLUMINATION PLAN
DETAILS	5	DO1	SIGNAL AND ILLUMINATION DETAILS
SIGNING AND PAVEMENT MARKING PLANS	6	C1.0	SIGNING AND PAVEMENT MARKING PLAN

Plans reviewed for compliance with City Standards and Policies

Application Number: **ENG-36298**

Recommended for Approval:

Fire Review	N/A	Date	
Water Review	N/A	Date	
Sewer Review	N/A	Date	
Grading (IBC Compliance)	N/A	Date	
Stormwater and Erosion Control	N/A	Date	
Transportation Review	<i>[Signature]</i>	Date	01/26/15
Traffic Review	<i>[Signature]</i>	Date	01/23/15
Planning Review	N/A	Date	

Improvement Summary:

Water Main Footage	0	LF	
Sewer Main Footage	0	LF	
Septic System Decommissioned	0	EA	
Total Hard Surface	0	SF	
Private Hard Surface	0	AC	
Grading	Cut 0	CY	Fill 0
Total Trenching within City Right of Way	0	LF	
Total Street Improvements (Curb/Pavmt)	0	LF	
Right of Way Dedication	0	SF	
Easements	Utility 0	SF Non-Util 0	SF 0

Full St Const.	0	LF	0	LF
Total Pavmt Add	0	SF	0	SF
Curb/Gutter	0	LF	0	LF
Sidewalk	0	SF	0	SF
Street Lights	0	#	0	#
Traffic Signals	0	#	0	#

RECORD DRAWING
Record drawings are intended to show the approximate location of constructed project components or features and do not represent the exact location of project elements. Furthermore, these record drawings have been prepared, in part, based on information furnished by others.

TRAFFIC ENGINEERING & OPERATIONS
P.O. BOX 1995
VANCOUVER, WA 98668-1995
360-487-8177
FAX: 360-487-8280

CONTACT: BILL GILCHRIST
PHONE: (360) 487-7717
EMAIL: WILLIAM.GILCHRIST@CITYOFVANCOUVER.US

KITTELSON & ASSOCIATES, INC.
TRANSPORTATION ENGINEERING/PLANNING
610 SW ALDER, SUITE 700
PORTLAND, OREGON 97205
(503)228-5230



APPROVAL BY: _____ APPROVAL BY: _____
TRAFFIC ENGINEERING MANAGER ENGINEERING MANAGER